

Grading Plan

P.E.
THOMAS J. MARANO
Lake County Engineer

By Tom J. Marano Date 3-30-88
#5741

ISSUED
3-30-88

SITE PLAN

6000 Townsend, Lake County, Ohio
for: Lehtinen-Hill Builders, Inc.

ADDRESS STREET CITY ZIP

SUBDIVISION 18-17 NAME Lehtinen-Hill Builders, Inc.
SUBLOT NO. 25 VOLUME 18-17 PAGE 1
PERMIT NO. 18-17 STREET

LEGEND	
	SANITARY MANHOLE
	STORM MANHOLE
	INLET OR CATCH BASIN
	HYDRANT
	EXISTING CONTOURS
	PROPOSED CONTOURS
	WATER VALVE (GAS)
	WATER METER (GAS)
	AS BUILT ELEVATION
	INDICATES DIRECTION OF SURFACE DRAINAGE

REMARKS

ALL BOUNDARY DATA SHOWN WAS OBTAINED FROM IDEEDS, RECORDED
SUBDIVISION PLAT OR OTHER PUBLIC RECORDS
LOCATIONS AS SHOWN OF ADJACENT WELLS AND SEPTIC TANKS OBTAINED FROM
LAKE COUNTY HEALTH DEPARTMENT

DESIGN CERTIFICATION

THIS PLAT WAS PREPARED BY ME, AND IS CORRECT
TO THE BEST OF MY KNOWLEDGE AND BELIEF.

NAME Harry S. Jones, Jr. SUPERVISOR REGISTRATION NO. 56343

CHECK LIST

NO. OF BEDROOMS	
1	2
3	4
5	6

PLAN PREPARED BY: BABCOCK & JONES & ASSOCIATES, INC.
PAINESVILLE, OHIO

REVISIONS	
NO.	DATE BY
1	3/1/88
2	3/1/88
3	3/1/88
4	3/1/88
5	3/1/88

"AS BUILT" CERTIFICATION

I, HEREBY CERTIFY THAT THE CIRCLED GRADES ARE EXISTING
FINISH GRADES CHECKED IN THE FIELD ON 3-19-88
AND ARE CORRECT TO THE BEST OF MY KNOWLEDGE AND BELIEF.

REGISTERED SUPERVISOR REG. NO. 56343

LOW YIELD WATER
FIXTURES REQUIRED
ON ALL:

Shower Head

Toilet

Hand

Wash

SINK

STOVE


Reviewed and Accepted
LAKE COUNTY GENERAL HEALTH DISTRICT
Date 3-28-88

JOEL LUGA, R. S. M. P. H.
Health Commissioner

By Tom J. Marano

HYDRAULIC PROFILE

SCALE: HORIZ. 1"=30'
VERT. 1"=5'

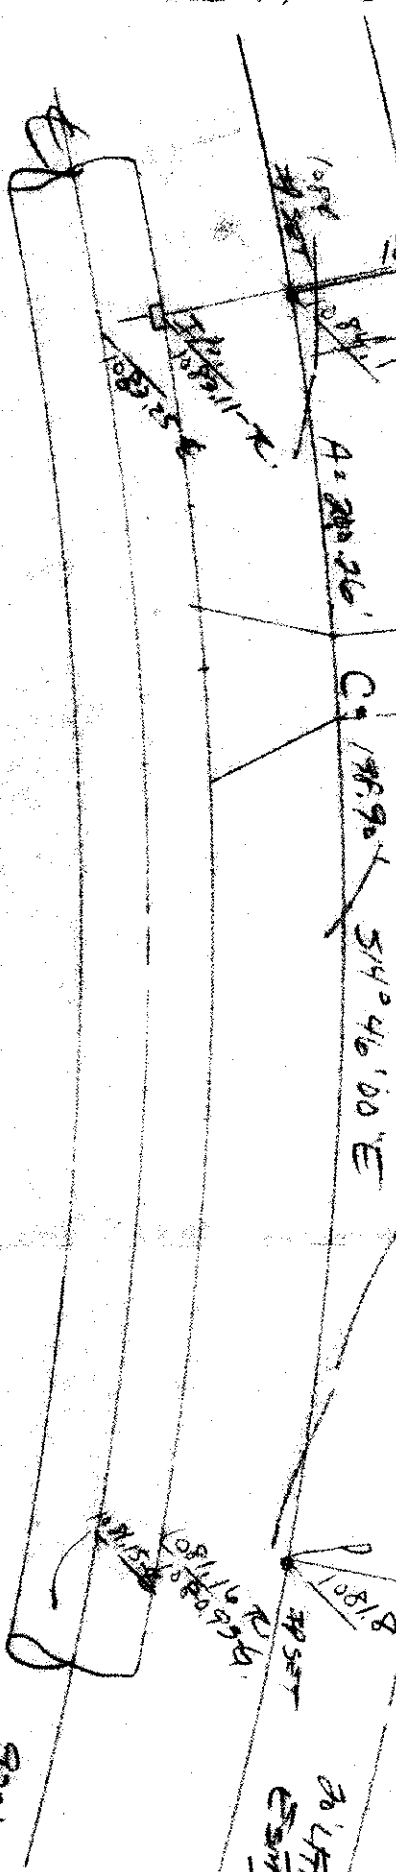

TELESPURVY LAKE - 60'

